3232

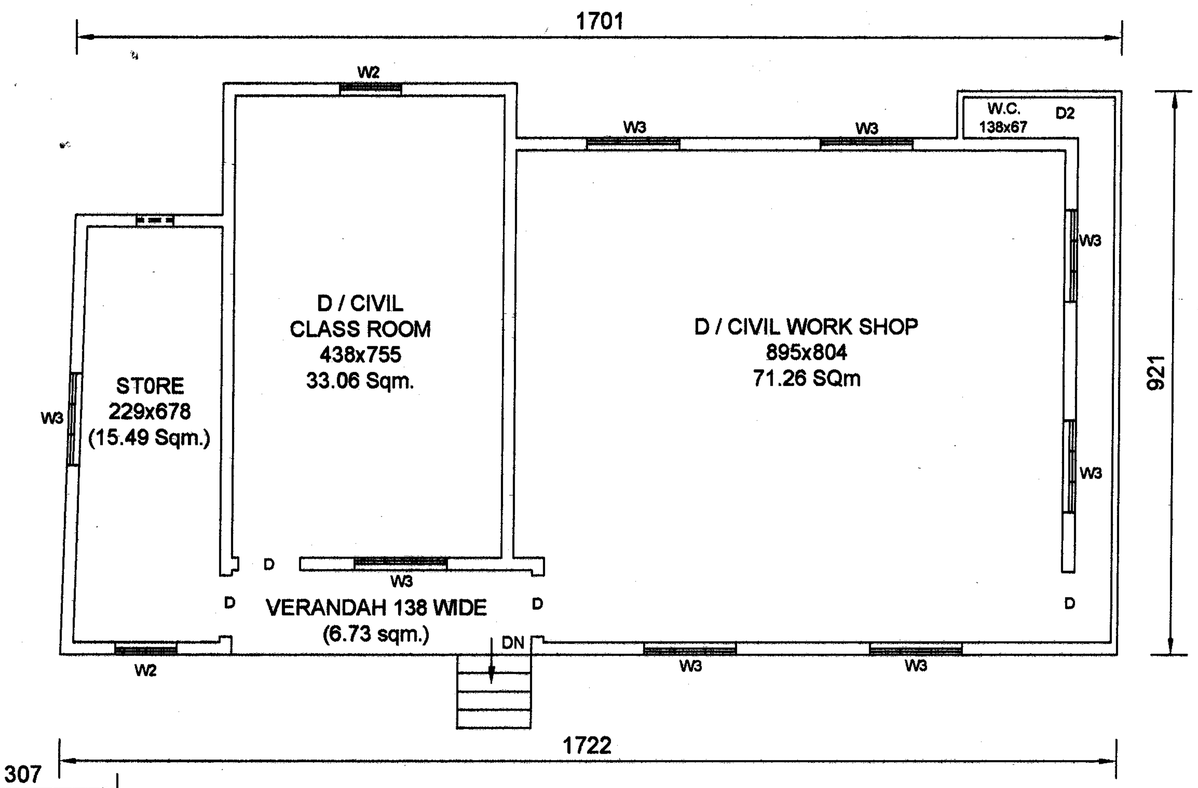

NEW BLOCK : FIRST FLOOR

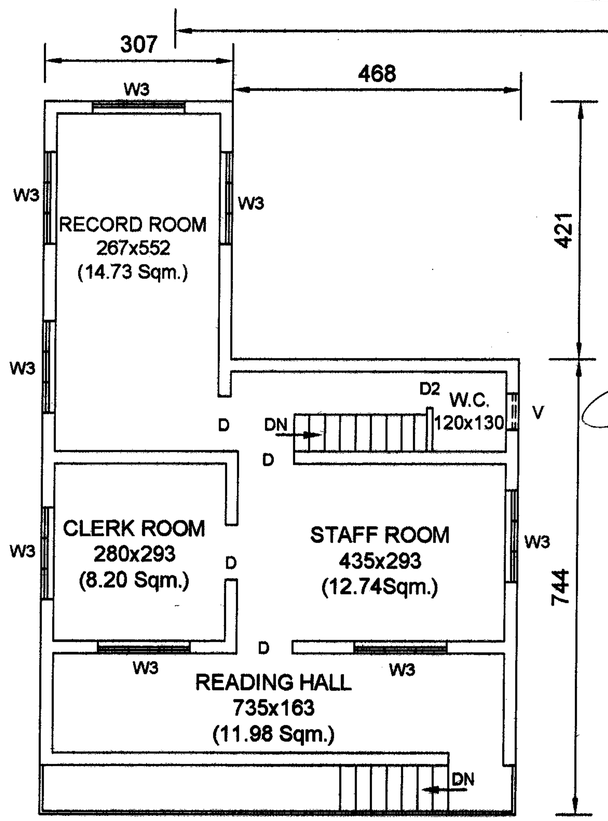

OLD BLOCK : FIRST FLOOR

A. KRISHNA KUMAR
INSPECTOR OF TRAINING
R.I. CENTRE, KALAMASSERY

C. R. VALSAMMA
Vice Principal
Industrial Training Institute
PALLICKATHODU

MOHAMMED ALI. N
Principal
Industrial Training Institute
for Woman, Kozhikode - 10

PRINCIPAL
KOMALA I T C, KOTTAKKAL
PIN: 676503, KERALA

AS BUILT PLAN OF EXISTING KOMALA ITC IN SURVEY No: 59/5,14 (BUILDING No: II / 2331 & 2331B) OF WARD II OF KOTTAKKAL GRAMA PANCHAYAT.

TITLE

PLAN: FIRT FLOOR

SCALE : 1 :100

ALL DIMENSIONS ARE IN cm

CLIENT

Mr. FAIZAL ABDULLA
MANAGER, KOMALA ITC
KOTTAKKAL.

PREPARED BY

Sajid Ali
Draughtsman

SIRAJ ASSOCIATES KOTTAKKAL LICENSED ENGINEERS

COUNTER SIGNED BY

RATHNAM. P.
SUPERVISOR-A,
REG. No: C1-24645/2000/460/SA,
Dept. of Municipal Administration, Kerala

Dwg. No:	Sheet No:
Date : 08-05-2008	2

Siraj Associates
Licensed Engineers & Architects
Opp. bus stand, Kottakkal, Malappuram Distt.
Tel: 0483 2743271; e-mail:sirajkottakkal@yahoo.com