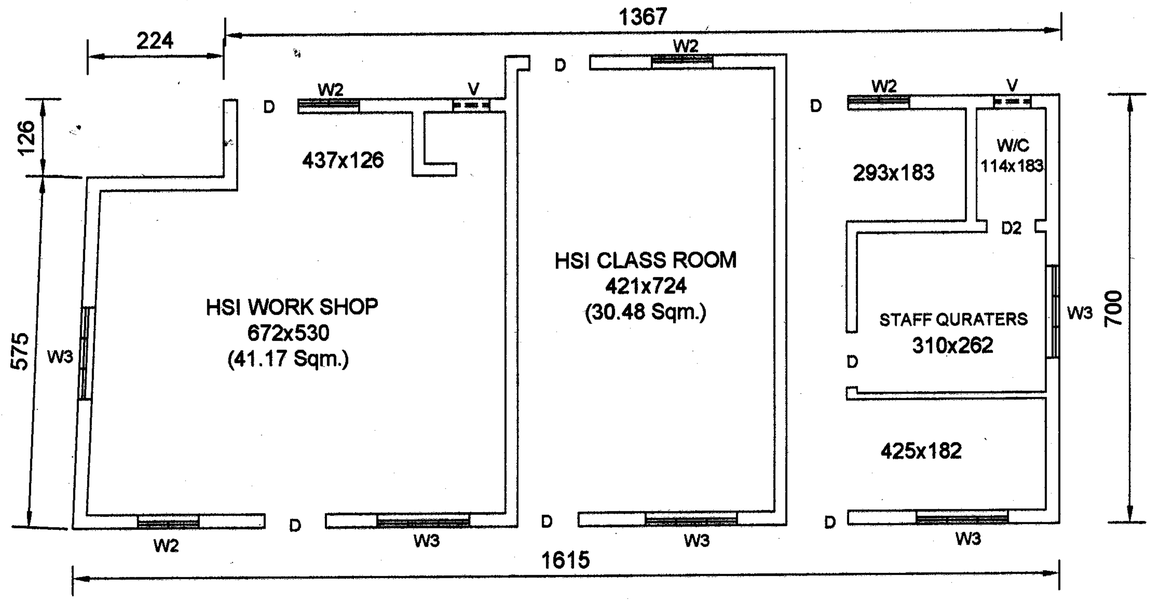

NEW BLOCK: GROUND FLOOR

BUILDING No: KP II / 2331B)

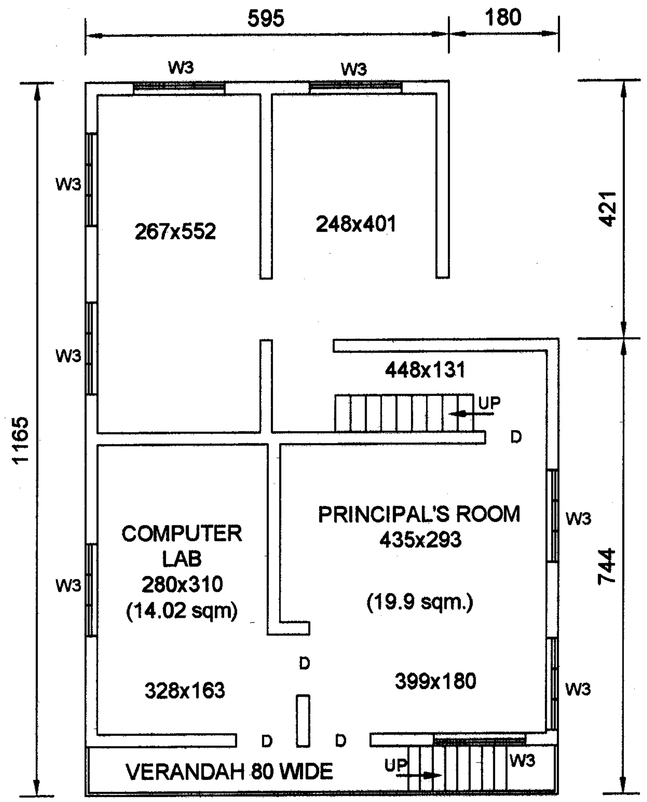

OLD BLOCK : GROUND FLOOR

(BUILDING No: KP II / 2331)

INDEX		
SYMBOL	ITEM	SIZE
D	DOOR	100x210
D2	DOOR	60x210
W3	WINDOW	150x140
W2	WINDOW	100x140
V	VENTILATOR	60x60

AREA DETAILS			
FLOORS		PLINTH AREA (Sqm.)	TOTAL
NEW BLOCK	G.F.	81.08	228.71
	F.F.	147.63	
OLD BLOCK	G.F.	53.32	117.70
	F.F.	64.38	
GRAND TOTAL			346.41

A. KRISHNA KUMAR
INSPECTOR OF TRAINING
R.I. CENTRE, KALAMASSERY

G. K. VALSAMMA
Vice Principal
Industrial Training Institute
PALLICKATHODU

MOHAMMEDALI. N
Principal
Industrial Training Institute
for Women, Kozhikode - 10

PRINCIPAL
KOMALA I T C, KOTTAKKAL
PIN: 676503, KERALA

AS BUILT PLAN OF EXISTING KOMALA ITC IN SURVEY No: 59/5,14 (BUILDING No: II / 2331 & 2331B) OF WARD II OF KOTTAKKAL GRAMA PANCHAYAT.

TITLE

PLAN: GROUND FLOOR

SCALE : 1 :100

ALL DIMENSIONS ARE IN cm

CLIENT

Mr. FAIZAL ABDULLA
MANAGER, KOMALA ITC
KOTTAKKAL.

PREPARED BY

Sajin Adatti
Chief Draughtsman

SIRAJ ASSOCIATES KOTTAKKAL LICENSED ENGINEERS & ARCHITECTS

COUNTER SIGNED BY

RATHNAM. P.
SUPERVISOR-A,
REG. No: C1-24645/2000/460/SA,
Govt. of Municipal Administration, Kerala

Dwg. No:	Sheet No:
Date : 08-05-2008	1

Siraj Associates
Licensed Engineers & Architects
Opp. bus stand, Kottakkal, Malappuram Distt.
Tel: 0483 2743271; e-mail:sirajkottakkal@yahoo.com