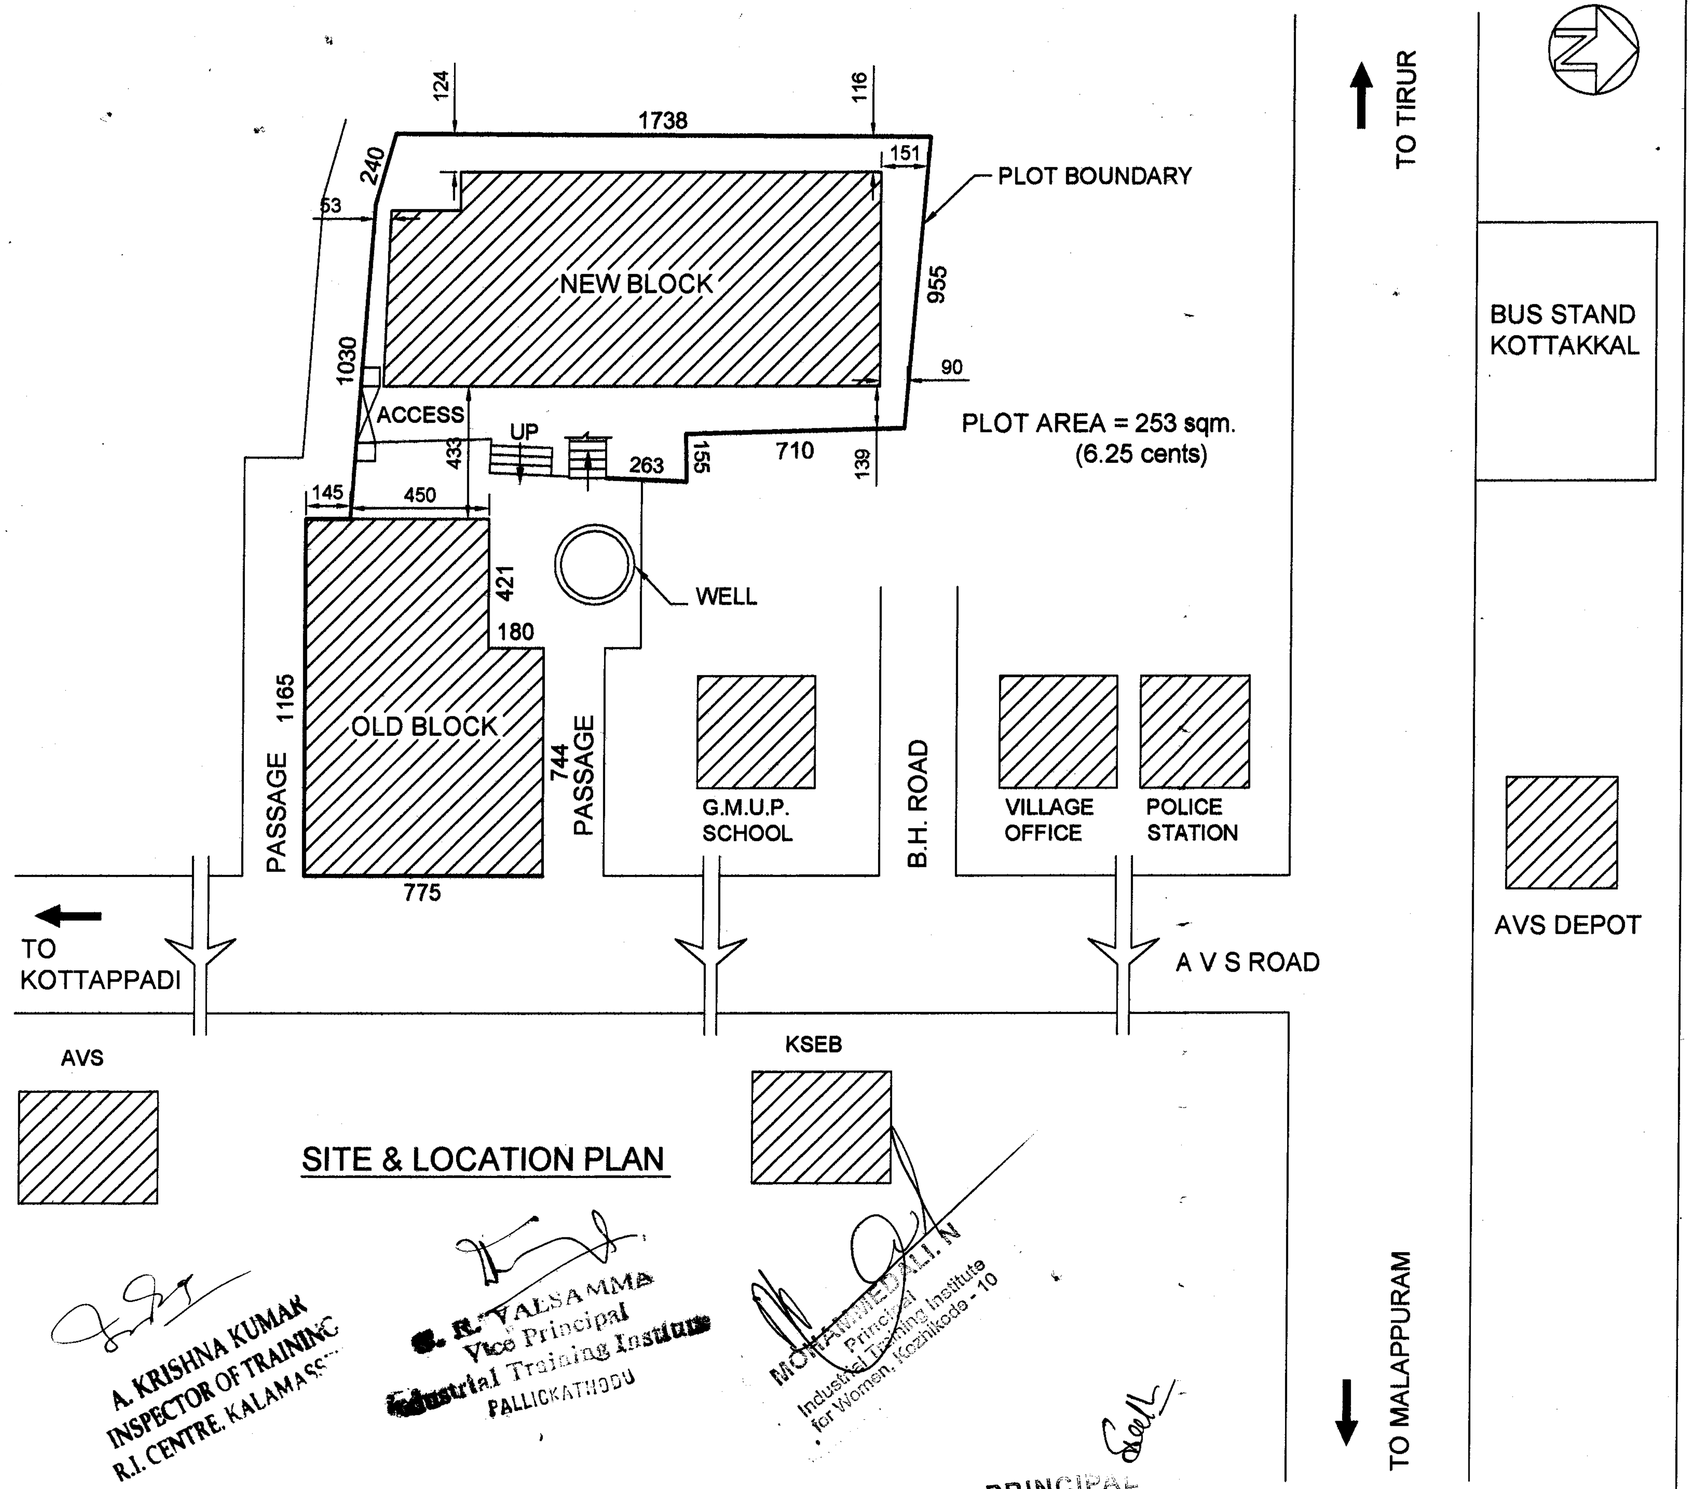

AS BUILT PLAN OF EXISTING KOMALA ITC IN SURVEY No: 59/5,14 (BUILDING No: II / 2331&2331B) OF WARD II OF KOTTAKKAL GRAMA PANCHAYAT.

TITLE

SITE & LOCATION PLAN

SCALE : 1 :200

ALL DIMENSIONS ARE IN cm

CLIENT

Mr. FAIZAL ABDULLA
MANAGER, KOMALA ITC
KOTTAKKAL.

PREPARED BY

Sajid Adatti
(Civil Draughts

SIRAJ ASSOCIATES KOTTAKKAL LICENCED ENGINEERS & ARCHITECTS

COUNTER SIGNED BY

RATHNAM. P.
SUPERVISOR-A,
REG. No: C1-24645/2000/460/SA
Govt. of Municipal Administration, Kerala

Dwg. No:	Sheet No:
Date : 08-05-2008	3

Siraj Associates
Licensed Engineers & Architects
Opp. bus stand, Kottakkal, Malappuram Distt.
Tel: 0483 2743271; e-mail:sirajkottakkal@yahoo.com

A. KRISHNA KUMAR
INSPECTOR OF TRAINING
R.I. CENTRE, KALAMASSERY

G. R. VALSAMMA
Vice Principal
Industrial Training Institute
PALLICKATHODU

MOHAMMED ALI. N
Principal
Industrial Training Institute
for Women, Kozhikode - 10

PRINCIPAL
I.T.C. KOTTAKKAL